


EQUIPMENT		
ITEM	DESCRIPTION	DIMENSIONS
DIV-02	WELL DIV-02 DIEVER	-
DS-200	KNOCK-OUT DROW / VENTSTACK	#930x1750 (T.L. TO T.L.)
PG-100	PG LAUNCHER	10"x12" L-3703
SL-100	4" SILENCER (FUTURE)	#508x2210 (DxL)
SP-100	SEPARATOR PACKAGE	13450x3700x4900 (LxBxH)
TA-300	DEG TANK	#2200x6090 (T.L. TO T.L.)
TA-400	FORMATION WATER TANK	#2500x8000 (T.L. TO T.L.)
WCU-900	WELL HEAD CONTROL PANEL	1200x400xH (LxBxH)
-	SANDFILTER (FUTURE)	# 8' x 1605 (DxL)

MISCELLANEOUS	
DESCRIPTION	DIMENSIONS
PLATFORM 1	2000x1200
PLATFORM 2 (FUTURE)	2800x1000
WALKOVER 1	2000x1000
WALKOVER 2	2075x1000

**GENERAL NOTES**  
 - DIMENSIONS ARE IN mm U.N.O.

REFERENCE DRAWINGS	
NUMBER	TITLE

**HOLDS:**  
 -

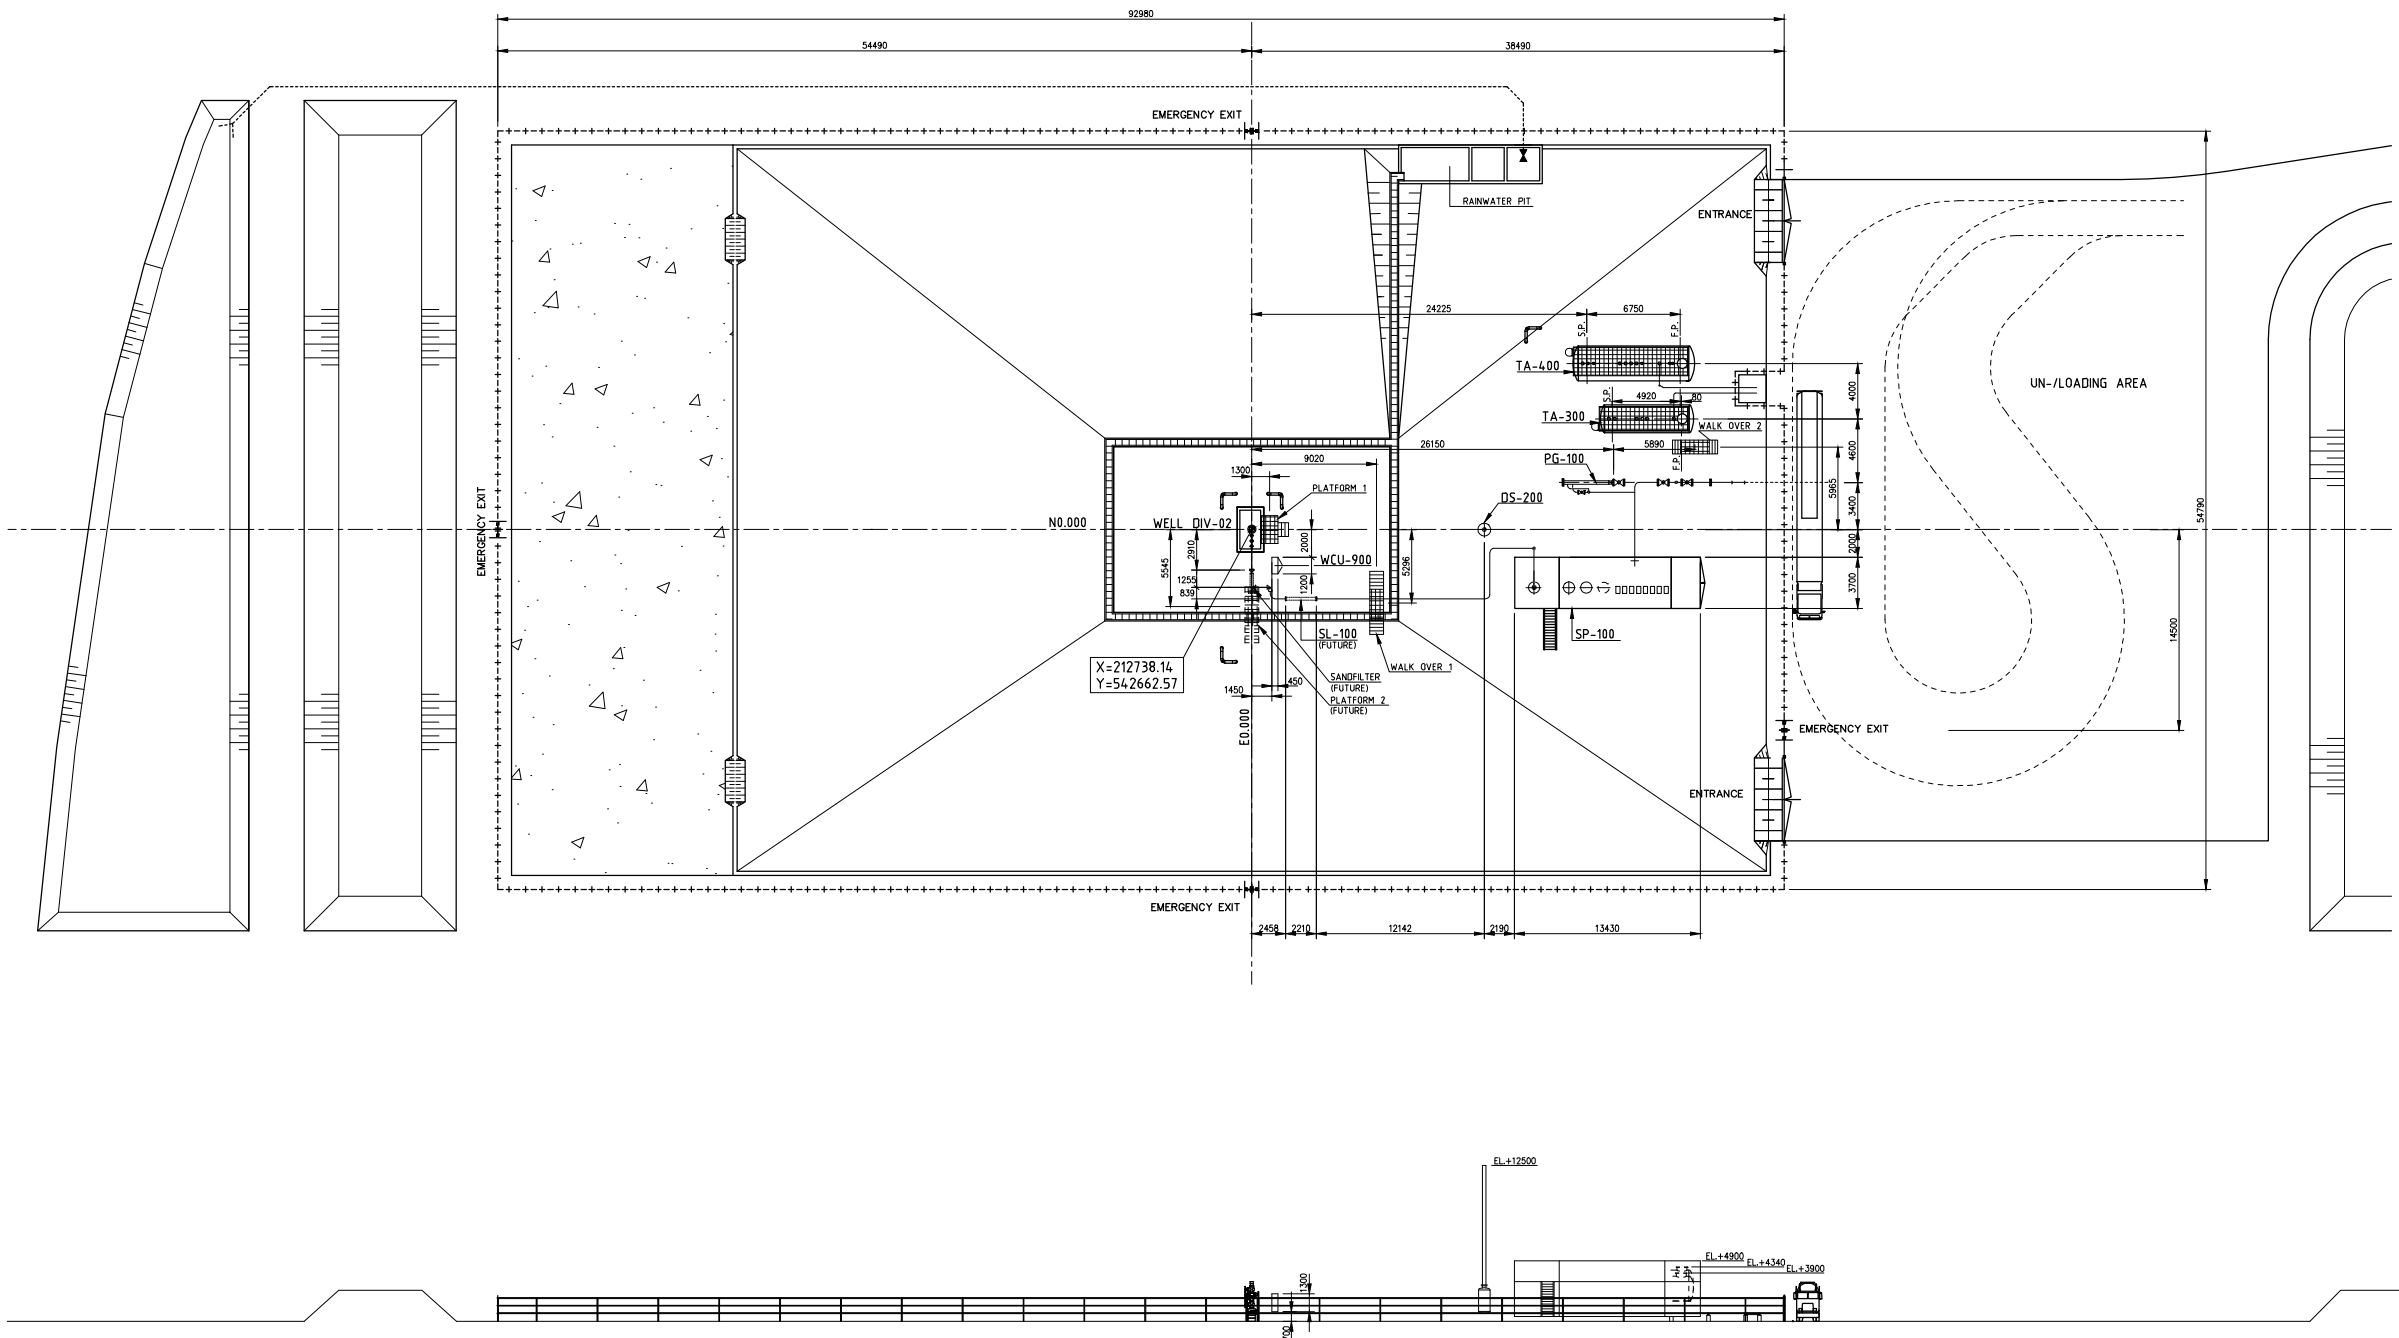

REV.	DATE	DESCRIPTION	DRWN	CHKD	APPR
T1	18-12-2015	AS BUILT DIV-02 PROJECT 209	RES	EHM	VAS
D	27-03-2015	FOR COMMENTS	CvH	EH	MSK

LOCATION: DIEVER  
 WELLS: DIV-02  
 TITLE: PLOTPLAN

SCALE: 1 : 200    SIZE: A0    DRAWING NUMBER: 1-52-WPS001-4-42-001    SHEET: 001